SKRA14M2V3

- ANTENNA P/N : HA -165H-MSMA1

SPECIFICATION

ELECTRICAL SPECIFICATION

Center Frequency	165MHz
VSWR	< 2.0
Impedance	50 Ω
Radiation	Omni Directional
Polarization	Vertical
Gain	Unity

MECHANICAL SPECIFICATION

Radiator	Φ1.3 SPW
Sleeve	Urethane
Cap	ABS
Connector	SMA-Female
Total Length	131 ± 3mm

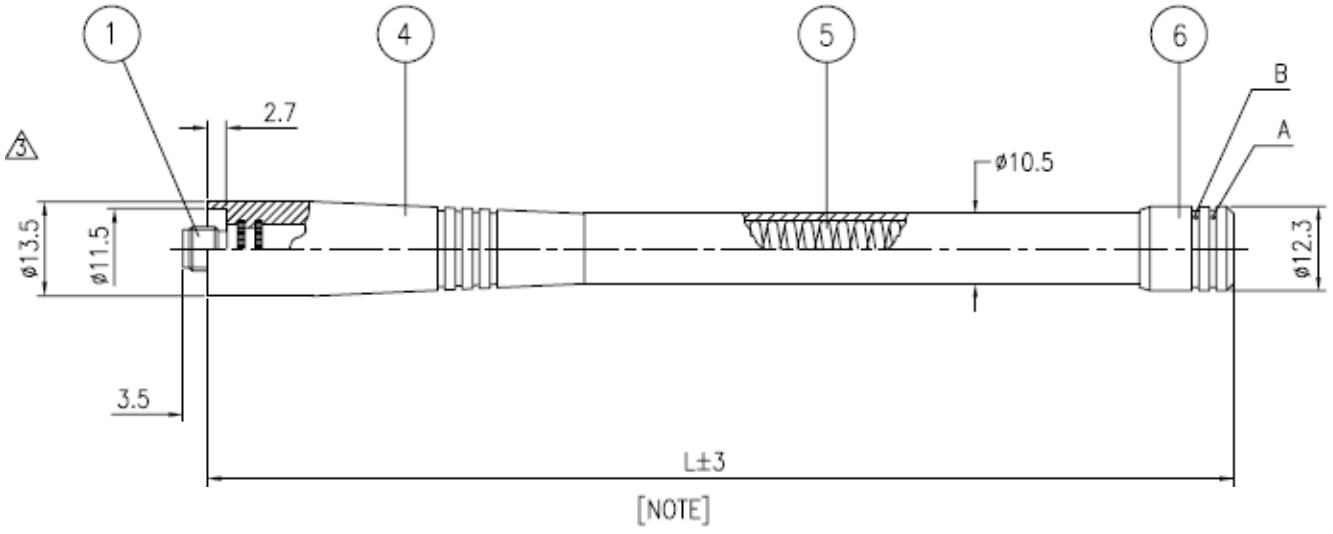

[NOTE]

DWG NO.	FREQ.(MHz)	L(mm)	LINE COLOR A	LINE COLOR B
11T-12-011	155	~~146~~ 2 141	GREEN	GREEN
11T-12-012	165	~~138~~ 2 131	BLUE	GREEN